

Suite: 530

RSF: 3,905

5700 Wilshire Blvd.
Los Angeles, CA 90036





As-Built Configuration

Offices.....	4
Conference/Huddle.....	1
Reception.....	1
Kitchen/Pantry.....	1
Open Work Area.....	+/-8

Key Plan

Not to scale, furniture and appliances not included

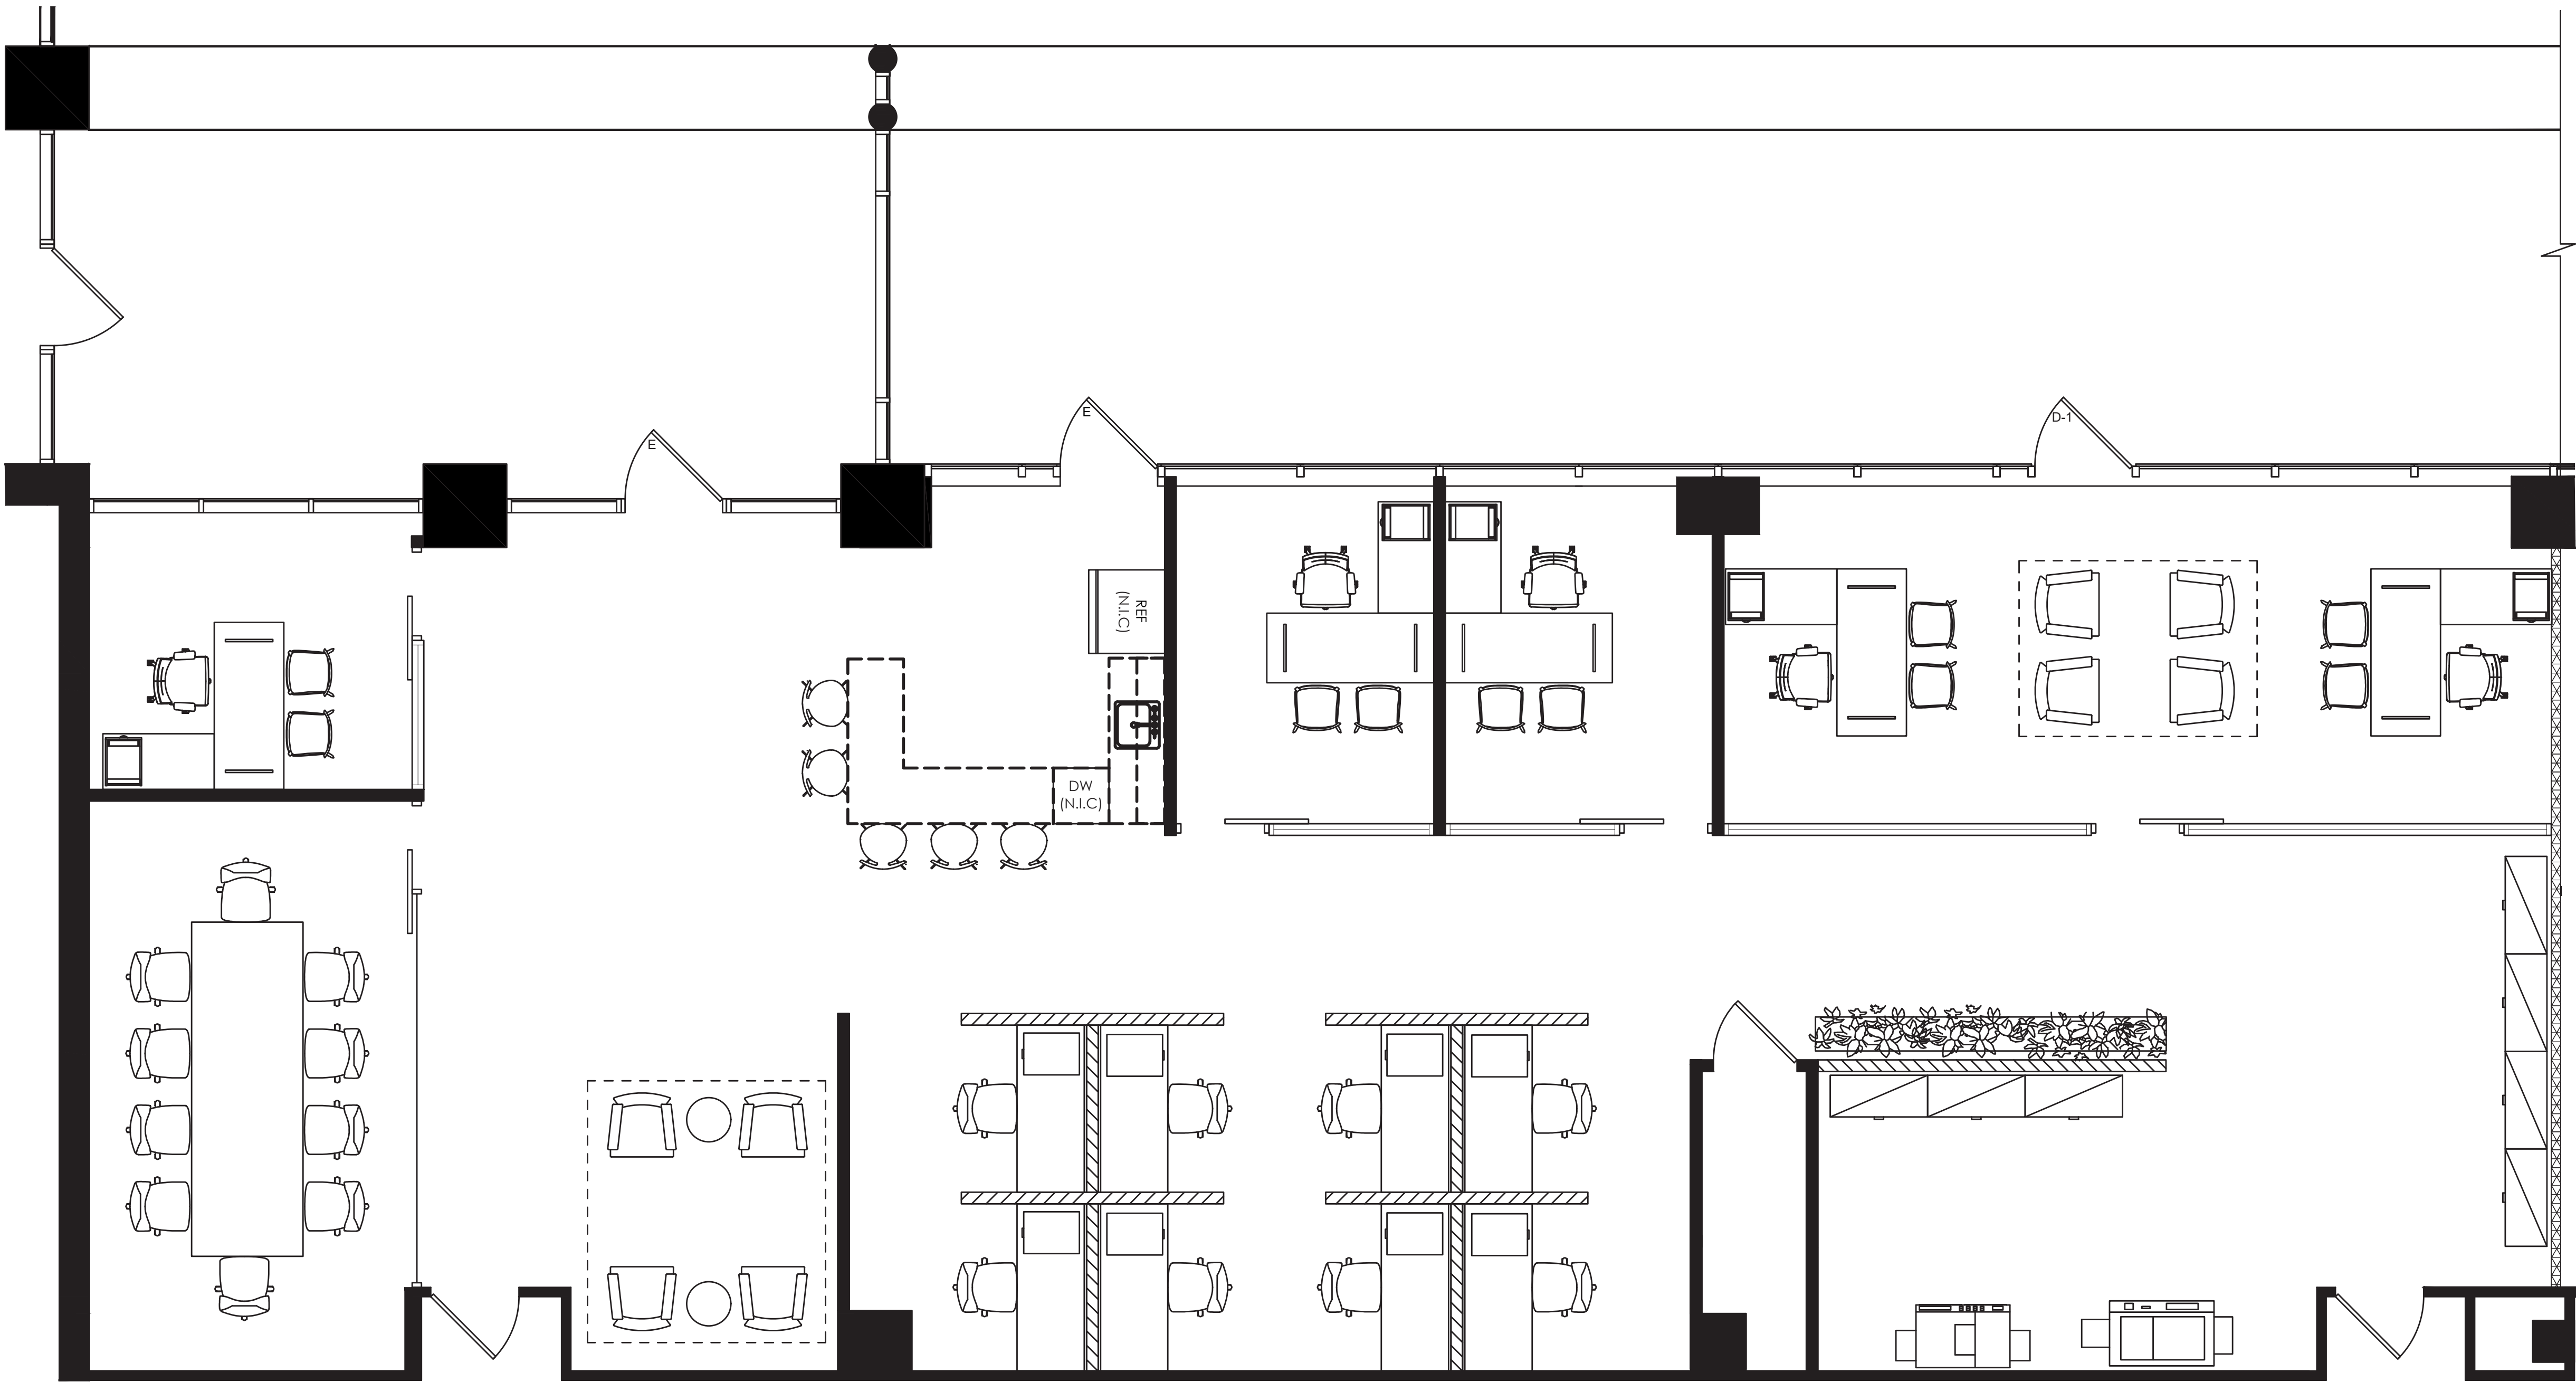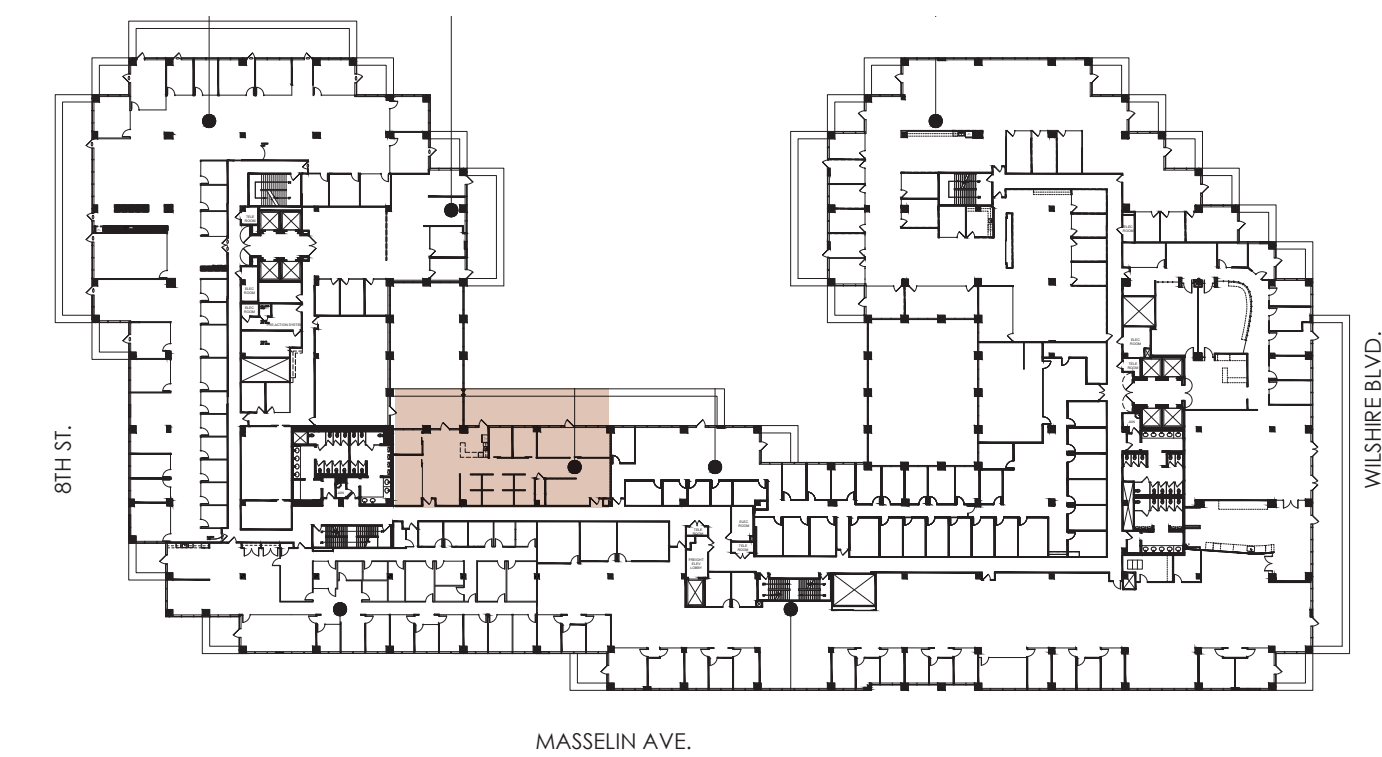

John Zanetos
Executive Vice President
+1 213 613 3704
john.zanetos@cbre.com

Kelli Snyder
Senior Associate
+1 213 613 3308
kelli.snyder@cbre.com

Chris Penrose
Senior Vice President
+1 213 613 3108
chris.penrose@cbre.com

Patrick Amos
Senior Vice President
+1 310 903 6904
patrick.amos@cbre.com

Rob Waller
Executive Vice President
+1 310 550 2536
rob.waller@cbre.com

Todd Doney
Vice Chairman
+1 213 593 1360
todd.doney@cbre.com

Dylan Hanseth
Associate
+1 805 637 5455
dylan.hanseth@cbre.com

