
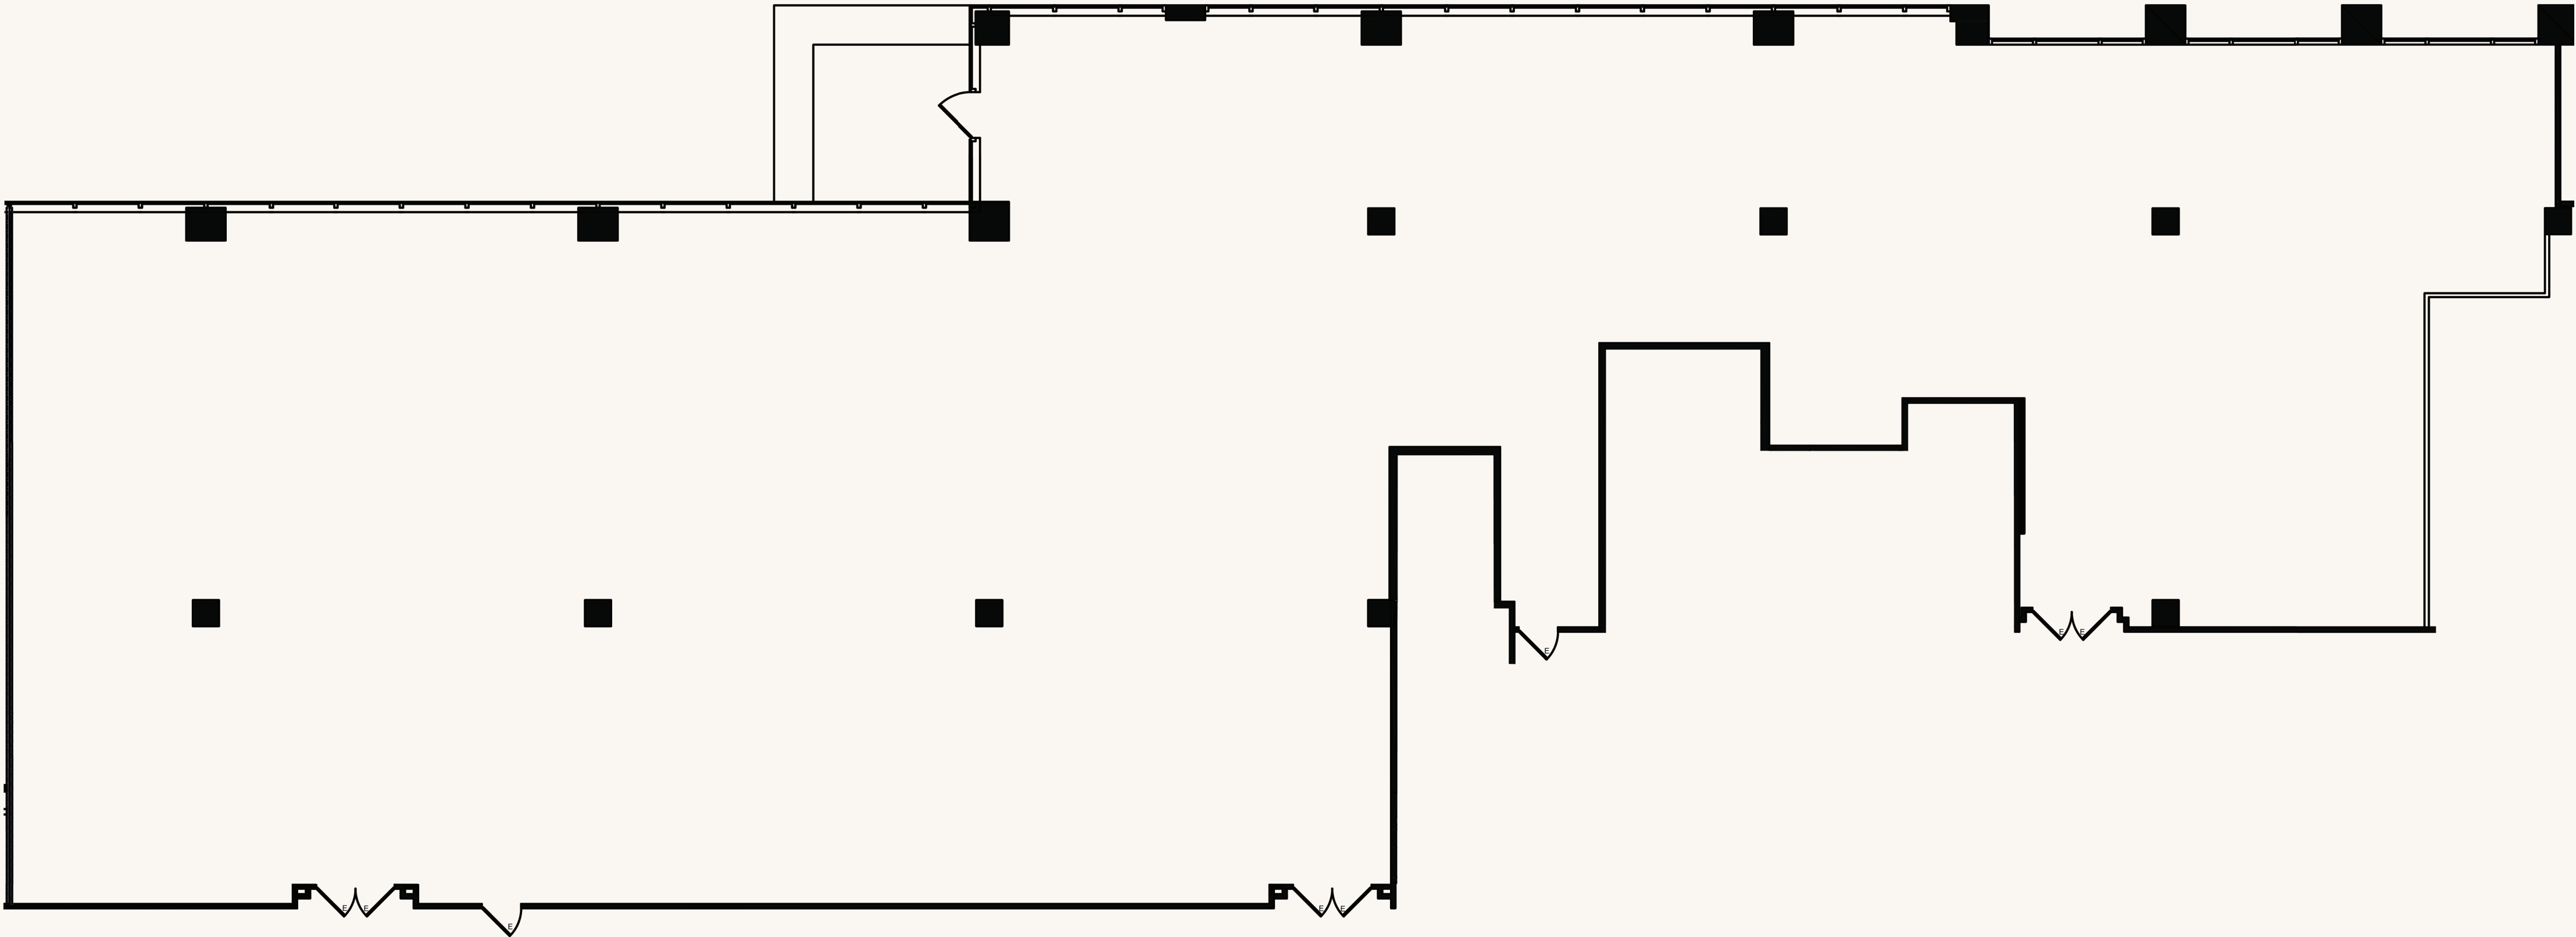


AS-BUILT CONFIGURATION

|                        |     |
|------------------------|-----|
| Offices.....           | N/A |
| Reception .....        | N/A |
| Conference/Huddle..... | N/A |
| Kitchen/Pantry .....   | N/A |
| Open Work Area .....   | N/A |

KEY PLAN

Not to scale, furniture and appliances not included

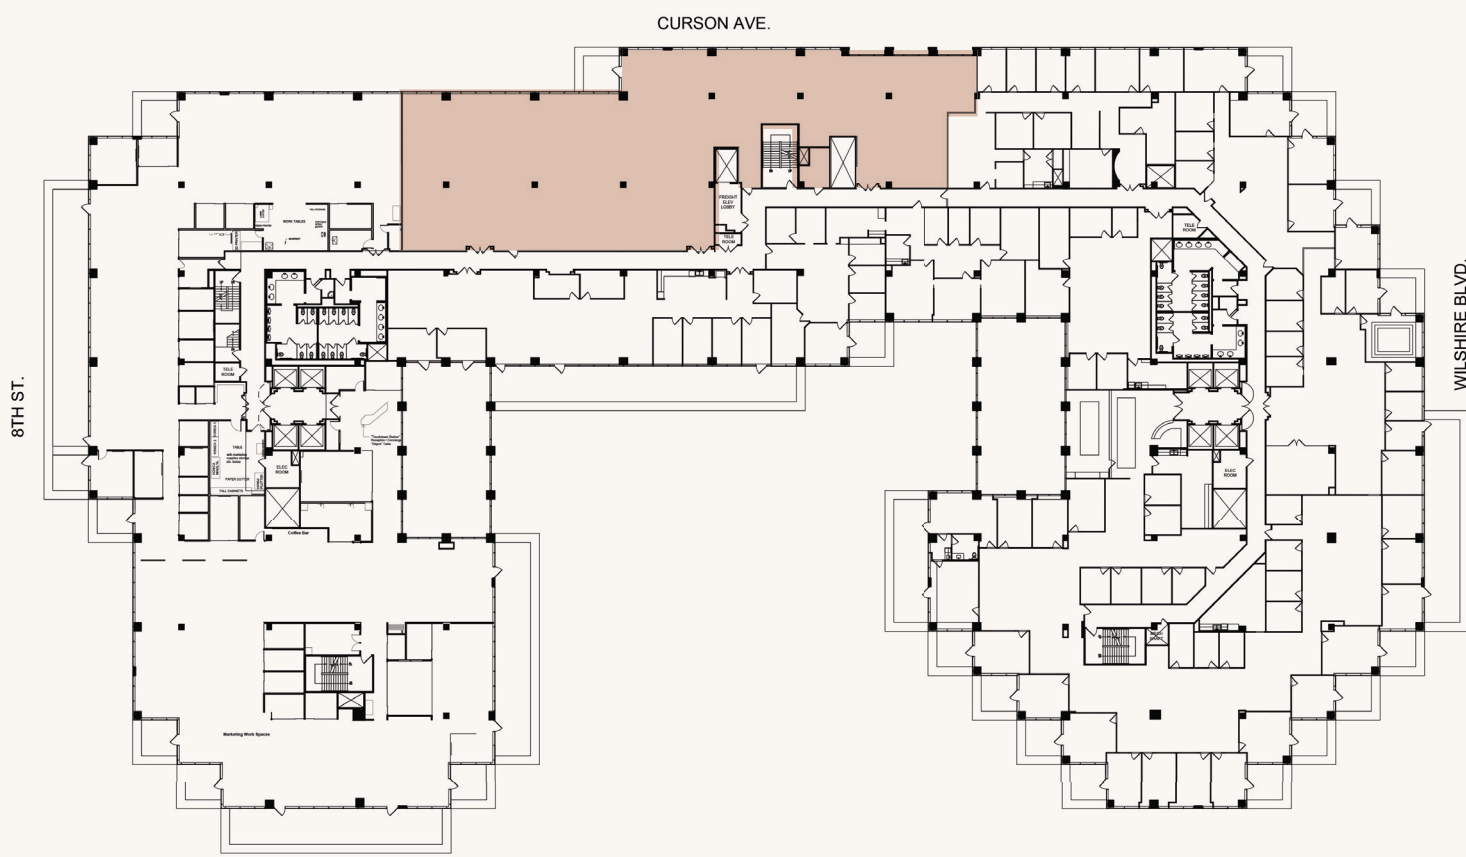

**John Zanetos**  
Executive Vice President  
+1 213 613 3704  
john.zanetos@cbre.com

**Kelli Snyder**  
Senior Associate  
+1 213 613 3308  
kelli.snyder@cbre.com

**Chris Penrose**  
Senior Vice President  
+1 213 613 3108  
chris.penrose@cbre.com

**Patrick Amos**  
Senior Vice President  
+1 310 903 6904  
patrick.amos@cbre.com

**Rob Waller**  
Executive Vice President  
+1 310 550 2536  
rob.waller@cbre.com

**Todd Doney**  
Vice Chairman  
+1 213 593 1360  
todd.doney@cbre.com

**Dylan Hanseth**  
Associate  
+1 805 637 5455  
dylan.hanseth@cbre.com